RECORD OF SURVEY NO.32-71

IN THE UNINCORPORATED TERRITORY OF THE COUNTY OF MONO, STATE OF CALIFORNIA, BEING A PORTION OF THE NORTHWEST QUARTER OF SECTION 16, TOWNSHIP 5 NORTH, RANGE 23 EAST, MOUNT DIABLO BASE AND MERIDIAN.

SURVEYOR'S STATEMENT:

THIS MAP CORRECTLY REPRESENTS A SURVEY MADE BY ME OR UNDER MY DIRECTION IN CONFORMANCE WITH THE REQUIREMENTS OF THE PROFESSIONAL LAND SURVEYOR'S ACT AT THE REQUEST OF TINA NAPPE IN SEPTEMBER,

\$8|\$9 \$17|\$16

BASIS OF BEARINGS S 00"28"56" W 5286.06" (R) S 00"28"56" W 5285.87" (M)

1/4 \$17 \$16

SFNF

S17 S16 S20 S21

RAYMOND WARBURTON L.S. NO. 8007

DATE 2-02-2010 LIC. EXP. 12-31-2010

COUNTY SURVEYOR'S STATEMENT:

THIS MAP HAS BEEN EXAMINED IN ACCORDANCE WITH SECTION 8766 OF THE PROFESSIONAL LAND SURVEYOR'S ACT THIS 6 DAY OF FRANCE 2010.

COUNTY SURVEYOR

OHN S. PARRISH S.. NO. 5050

2-8-2010 DATE LIC. EXP. 6/30/10

RECORDER'S STATEMENT:

INSTRUMENT NO. : 2010000591 . FILED THIS 9th DAY OF FERRYAY 2010, AT 1:30 P.M. IN BOOK 4. OF RECORD OF SURVEY MAPS AT PAGE 75 AT THE REQUEST OF TINA NAPPE.

LYNDA ROBERTS MONO COUNTY RECORDER

BY: Sheni & DEPUTY COUNTY RECORDER

TOIYABE N.F.

PARCEL 2 PMB 1/43 19.72 ACRES

N 87°13'54" E 1294.74' (R)

N 87°16'29" E 1294.87' (M)


PARCEL 3


PMB 1/43 19.69 ACRES

N 86°58'43" E 1300.74' (R)

N 86°59'48" E 1300.39' (M)

PARCEL 4 PMB 1/43

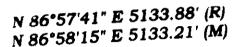

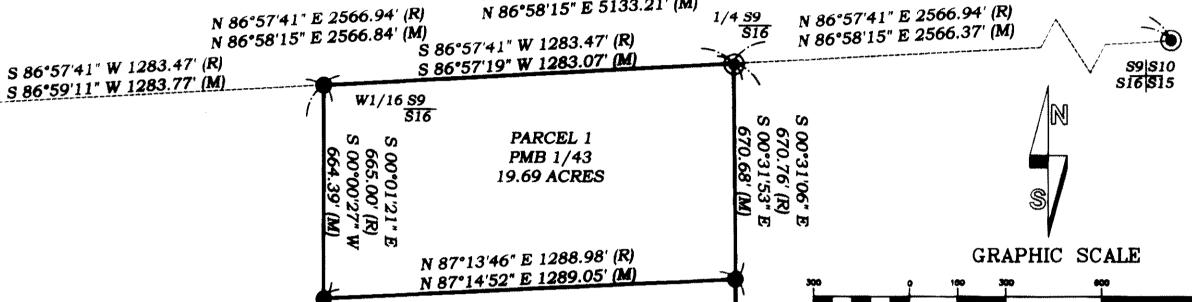

LEGEND

- FOUND 2" IRON PIPE WITH TAG RCE 10467
 - FOUND 1" IRON PIPE WITH TAG RCE 10467
- RECORD DATA PER PMB 1/43

(IN FEET) 1 inch = 300 ft.

(SFNF) SEARCHED FOR NOT FOUND

TOIYABE S 00*31'06" E 659.00' (R) S 00*30'16" E

N.F.

N 00°31'06" W 5384.40' (R) N 00°30'47" W 5384.45' (M)

00°31'06" E 3389.84' 00°30'36" E 3389.66'

<u>\$16</u> \$21

1/4

RECORD DATA PER PMB 1/58

S 00°01'21" E 5335.03' (R) S 00°00'58" E 5334.63' (M)

TOIYABE N.F

5 00°01'21" E 665.00' (R) 5 00°03'07" E 664.99' (M)

H

PMB 1/58

N 89°11'59" E 1328.10' (P)

PURPOSE OF SURVEY:

THE REASON FOR THIS RECORD OF SURVEY IS AS SET FORTH IN THE PROFESSIONAL LAND SURVEYORS ACT, ARTICLE 5, 8762(b)(2): A MATERIAL DISCREPANCY WITH THE INFORMATION CONTAINED IN ANY SUBDIVISION MAP, OFFICIAL MAP, OR RECORD OF SURVEY PREVIOUSLY RECORDED OR FILED IN THE OFFICE OF THE COUNTY RECORDER OR THE COUNTY SURVEYING DEPARTMENT, OR ANY MAP OR SURVEYED RECORD MAINTAINED BY THE BUREAU OF LAND MANAGEMENT OF THE UNITED STATES. FOR THE PURPOSES OF THIS SUBDIVISION, A "MATERIAL DISCREPANCY" IS LIMITED TO A MATERIAL DISCREPANCY IN THE POSITION OF POINTS OR LINES, OR IN DIMENSIONS.

BASIS OF BEARINGS

THE WEST LINE OF SECTION 16 PER PARCEL MAP BOOK 1, PAGE 43, SHOWN HEREON AS S 00°28'56" W.

SFNF N 89°11'08" E 1328.40' (R+R1) N 89°11'08" E 1328.41' (R+R1) N 89°11'59" E 1328.11' (P)

19 SHANNA CIRCLE Mammoth Lakes, CA N 89°11'08" E 2656.81' (R+R1) N 89°11'59" E 2656.21' (M)

RECORD SURVEY MAPS